




1600 SOUTH MAIN PLAZA, WALNUT CREEK, CA
PROPERTY MANAGER, GREG ERICKSON
TEL: 925-937-1605 • FAX: 925-944-1605
EMAIL: REQUESTS@WCSSIPROPERTIES.COM


SUITE 185
SOUTH TOWER

Approx. Area Space:
2,004 Square Feet

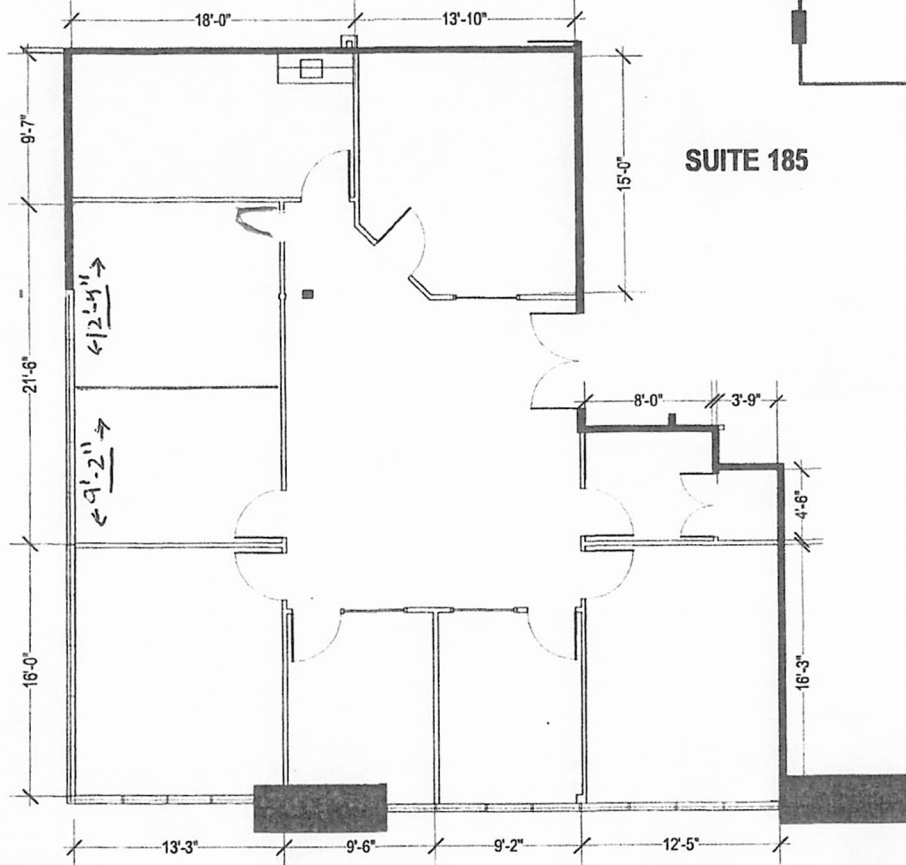

KEY PLAN SOUTH BUILDING - FLOOR 1

SUITE 185

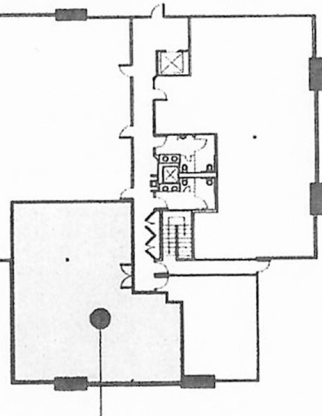

SUITE FLOOR LOCATION

AS-BUILT PLAN
REVISION 10-29-24